City of Camas WASHINGTON

Contract Change Order

Order No.: 5 Date: November 16, 2015

Contract for S-565 NW 38th Ave. Roadway Improvements, Ph. 2

To: Nutter Corp.
(Contractor)

You are hereby requested to comply with the following changes from the contract plans and specifications:

Description of Changes

A. ***Removal of Existing Pavement Markings – NW 38th Ave. – East of NW Fisher Creek Pl. (Approx. Sta 33+41 to Sta 37+00):***
The original contract did not include a bid item for "Removing Paint Line". The Contractor was required to remove the existing pavement markings from the Phase 1 improvements that conflicted with the Phase 2 pavement markings.

Striping Removal Quantity = 987 LF @ $0.85/LF = $838.95

Increase = $838.95
Contractor P&O (12%) = $100.67

Net Change in Contract Price = $939.62

NOTE: Verbal approval given to the Contractor on Monday, June 8, 2015 by the Project Engineer, Anita Ashton. Payment at this time due to Contractor failed to supply documentation at completion of work.

The amount of the contract, prior to sales tax, will be (decreased) (**increased**) (unchanged) by the sum of: nine hundred thirty-nine dollars and sixty-two cents ($939.62).

The contract total, including the original contract total, this and previous change orders will be: four million one hundred forty-one thousand two hundred ninety-one dollars and thirty-eight cents ($4,141,291.38). **Sales tax is included in this total.**

The contract period provided for completion will be (increased) (decreased) (**unchanged**): 0 days.

This document will become a supplement to the contract and all provisions will apply hereto.

Requested	James Hodges Project Manager	11/9/2015 Date
Recommended	Jim E. Carothers Engineering Manager	11-9-2015 Date
Accepted	[signature] Contractor	11-9-2015 Date
Approved	Scott [signature] Mayor	Date

File: R:/Projects/Streets/S-565 NW 38th Imp Ph.2/Construction Stuff/Pay Estimates & Change Orders/ Change Order #5/S-565_Change Order_5_PavementMarkingRemoval

APPLY-A-LINE, INC.

175 Roy Road SW, Bldg C • Pacific, WA 98047
Phone (253) 299-1200 • Fax (253) 299-1250
mail@applyaline.com • LIC. #APPLYI*161RU

Bill To: 2NUT01
NUTTER CORPORATION
7211-A NE 43RD AVE
VANCOUVER, WA 98661-1311

Invoice No: 4035
Invoice Date: 6/20/2015

Job Info: 103N4154
NW 38TH AVE RDWY IMPVTS PHS 2
CAMAS, CLARK, WA (0602)
CAMAS, WA . CLARK

Period To: 6/20/2015
Application #: 1
Pay Request: No

1) Original Contract Amount 10,349.85
2) Change Order Amount 0.00
3) Contract Sum 10,349.85
4) Completed to Date 8,476.86
5) Retainage 0.00
6) Total Earned less Retainage 8,476.86
7) Previous Billings 0.00
8) Current Payment Due 8,476.86
9) Sales Tax 0.00
10) Total Due 8,476.86

Contract #: S-565 Cust PO #: 14-0111

ITEM NO.	DESCRIPTION	UNIT MEAS	CONTRACT QUANTITY	UNIT PRICE	QTY TO DATE	PREVIOUS QTY	CURRENT QTY	CURRENT AMT DUE	
A78 -5310	PAINT LINE	LF	5,655	0.23	6,881	0	3837 ~~6,881~~	1,582.63	
A79 -5310	PAINTED WIDE LINE	LF	5,960	0.32	6,169	0	6610 6,169	1,974.08	
A80 -5310	PLASTIC ARROW	EA	14	95.00	5	0	5	475.00	
A81 -5310	PLASTIC X-WALK	SF	180	4.65	368	0	368	1,711.20	
A82 -5310	PLASTIC STOP LINE	LF	46	5.00	67	0	69 ~~67~~	335.00	
A83 -5310	PLASTIC BIKE SYMBOLS	EA	13	255.00	4	0	5 ~~4~~	1,020.00	
A70 -5310	Lane Markers Truck Installatio	HD	1.45	400.00	1.35	0	1.35	540.00	ES
ADD1	STRIPE REMOVAL 506	8170 LF	1,000	0.85	987	0	987	838.95	ES
								8,476.86	

not billed @ 6-30-15

14011

CP 7-13-15

RECEIVED

Area of Pavement Marking Conflict with Phase I

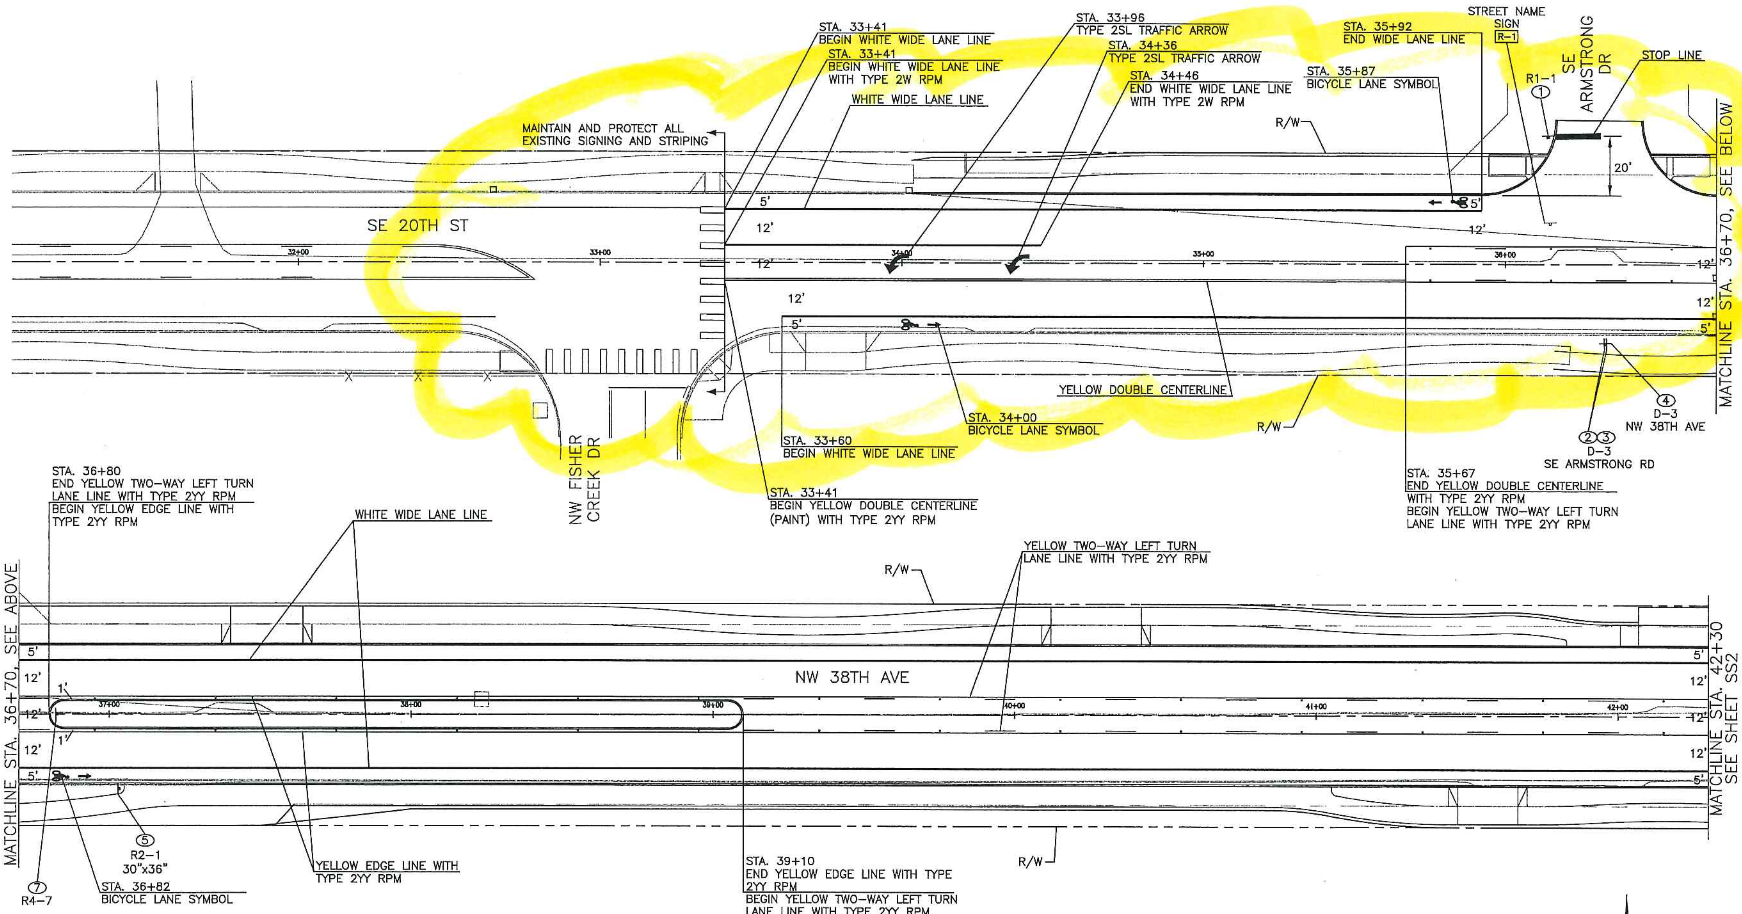

GENERAL NOTES:

1. REMOVE ANY EXISTING PAVEMENT MARKINGS THAT CONFLICT WITH THIS PLAN.
2. ALL LONGITUDINAL LINES SHALL BE PAINT WITH SMALL GLASS BEADS. ALL ARROWS AND LEGENDS SHALL BE TYPE B PRE-FORMED FUSED THERMOPLASTIC. ALL CROSSWALKS, STOP LINES, AND OTHER TRANSVERSE MARKINGS SHALL BE TYPE A LIQUID HOT APPLIED THERMOPLASTIC. THERMOPLASTIC MARKINGS SHALL CONFORM TO WSDOT STANDARD SPECIFICATIONS, INCLUDING SKID RESISTANCE.
3. SEE CITY OF CAMAS STANDARD DETAIL ST30 FOR CROSSWALK AND WSDOT STANDARD PLAN M-15.10 FOR STOP LINE LAYOUT DETAILS.
4. SEE WSDOT STANDARD PLANS M-20.10, M-20.30, AND M-20.40 FOR LONGITUDINAL MARKING PATTERNS.
5. SEE WSDOT STANDARD PLANS M-24.20 AND M-24.60 FOR SYMBOL DETAILS. SEE CITY OF CAMAS STANDARD DETAIL ST33 FOR BIKE LANE SYMBOL.
6. DOUBLE CENTERLINE (YELLOW) NARROW PATTERN DISTANCE BETWEEN THE LINES IS 4 INCHES.
7. SEE WSDOT STANDARD PLANS G-20.10 AND G-24.50 FOR SIGNING DETAILS. USE WSDOT SIGN SUPPORT TYPE ST-4.

SIGNING:

- # NEW SIGN NOTE, SEE DETAILS AND LEGENDS ON SHEET SS4
- R-# REMOVE EXISTING SIGN ASSEMBLY
- EXISTING SIGN
- PROPOSED SIGN

3'-0"
1'-0" 2"D Private Rd
2"C SE Armstrong Dr 4"C
② & ③

3'-3"
0'-9" 4"C NW 38th Ave 6"C
④

-N-

GRAPHIC SCALE 20 0 10 20 40

DKS 720 SW Washington Street, Suite 500 Portland, Oregon 97205 (503) 243-3500 www.dksassociates.com

CALL 2 BUSINESS DAYS BEFORE YOU DIG 1-800-424-5555 "it's the law" A FREE SERVICE
CLARK COUNTY UTILITIES COORDINATING COUNCIL

DATES	
DESIGN DATE:	APRIL 2014
AS-BUILT DATE:	
SCALES	
HORIZONTAL:	AS SHOWN
VERTICAL:	AS SHOWN
CONTACTS	
DESIGNED BY:	JKW
APPROVED BY:	DMB
PROJ. ENGR.:	DMB

City of Camas WASHINGTON
616 NE 4TH AVENUE CAMAS, WA 98607 PH:(360) 834-3451

COMMUNITY DEVELOPMENT
ENGINEERING DEPARTMENT
NW 38TH AVENUE Ph.3
NW FISHER CREEK DR TO NW PARKER RD
SIGNING & PAVEMENT MARKING PLANS

DANA M. BECKWITH STATE OF WASHINGTON 39179 REGISTERED PROFESSIONAL ENGINEER

CAMAS PROJECT NUMBER S-565
STATUS: DRAFT / ☒ CONSTRUCTION / AS-BUILT
PAGE 60 OF 77
CAMAS DRAWING NUMBER SS1
CAMAS CATALOG NUMBER

X:\Projects\2012\P12171-000 (Camas NW 38th Ave-SE 20th St Imps.)\ACAD\SS-01.dwg

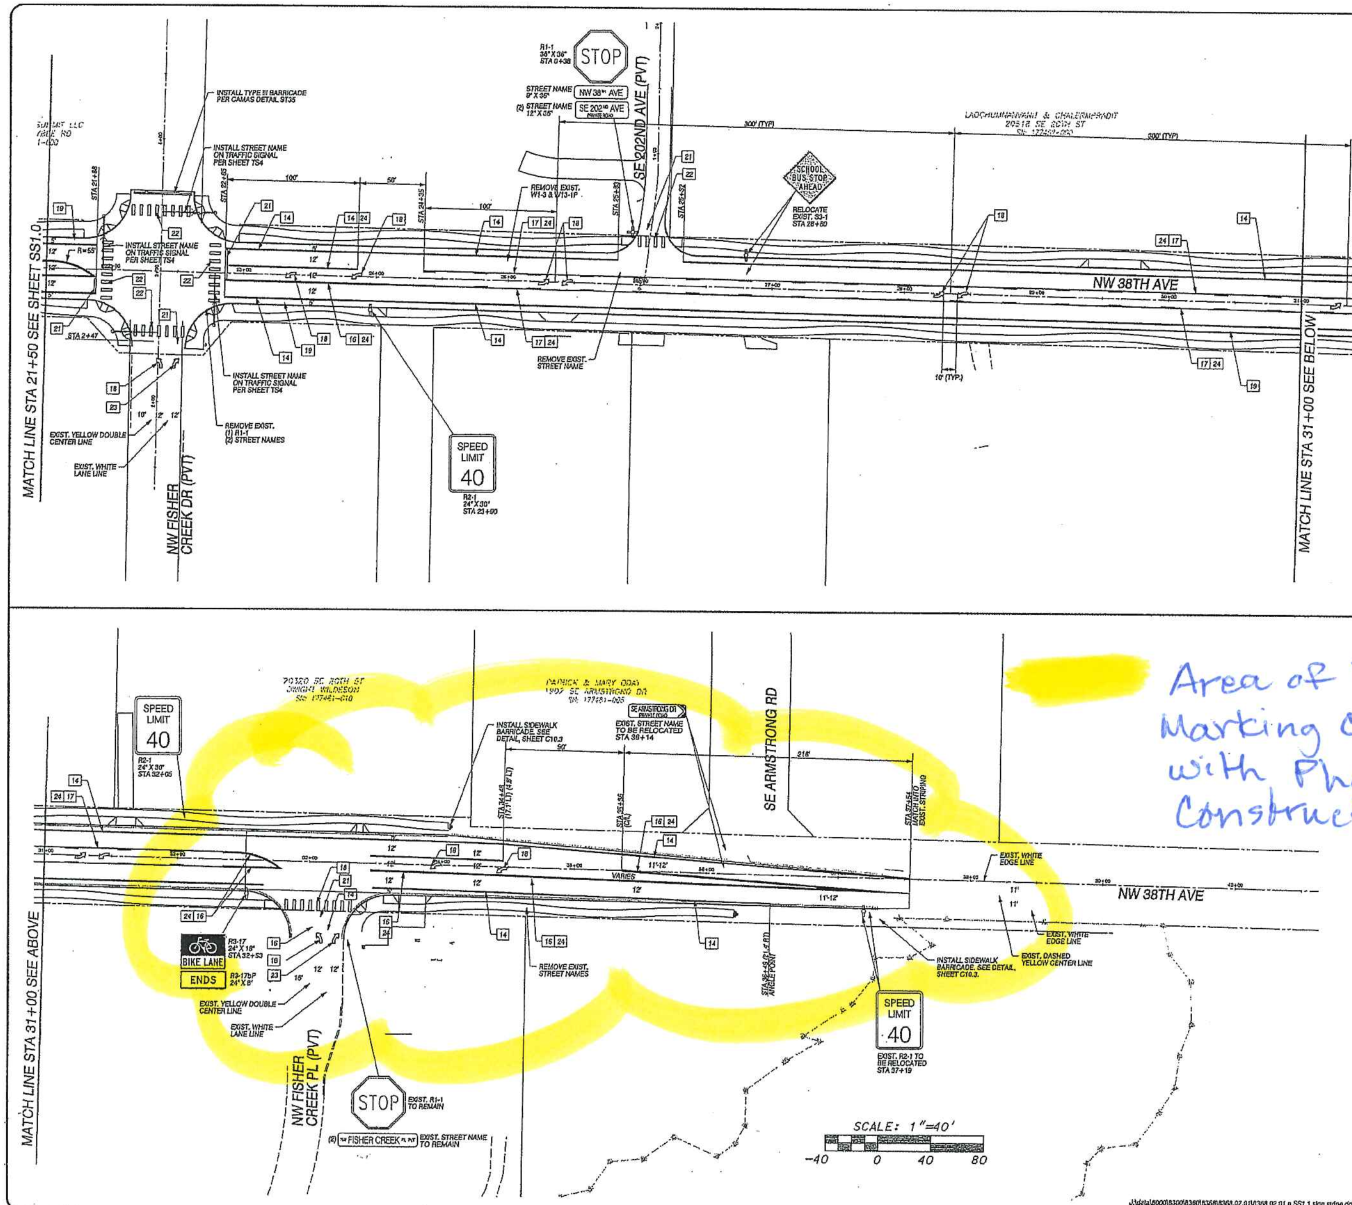

CONSTRUCTION NOTES

STRIPING NOTES

SEE CITY OF VANCOUVER STRIPING NOTES AND DETAILS IN THE CONTRACT DOCUMENTS.
SEE WSDOT STRIPING DETAILS IN THE STANDARD PLANS MANUAL.
SEE CITY OF CAMAS STRIPING NOTES IN THE CONTRACT DOCUMENTS.

- 14 INSTALL WIDE LANE LINE (WHITE) PER WSDOT DETAIL M-20.10-02
- 15 INSTALL EDGE LINE (YELLOW) PER WSDOT DETAIL M-20.10-02
- 16 INSTALL DOUBLE CENTER LINE (YELLOW)(NARROW PATTERN) PER WSDOT DETAIL M-20.10-02
- 17 INSTALL TWO-WAY LEFT TURN CENTER LINE PER WSDOT DETAIL M-20.10-02
- 18 INSTALL TYPE 2SL (LEFT) TRAFFIC ARROW PER WSDOT DETAIL M-24.40-01
- 19 INSTALL BICYCLE LANE SYMBOL PER CAMAS DETAIL ST33
- 20 INSTALL EDGE LINE (WHITE) PER WSDOT DETAIL M-20.10-02
- 21 INSTALL STOP LINE PER WSDOT DETAIL M-24.60-03
- 22 INSTALL CROSS WALK PER CAMAS DETAIL ST30
- 23 INSTALL TYPE S2R (RIGHT) TRAFFIC ARROW PER WSDOT DETAIL M-24.40-01
- 24 INSTALL W/ RPM's PER WSDOT DETAIL M-20.40-02
- 25 INSTALL W/ RPM's PER WSDOT DETAIL M-20.30-02

SIGNING NOTES

1. SIGNS IN CITY OF CAMAS R.O.W. TO BE PLACED PER WSDOT DETAIL G-20.10-00 IN THE CONTRACT DOCUMENTS.
2. SIGNS IN CITY OF CAMAS R.O.W. SHALL USE POSTS AND BE MOUNTED (SIGN SUPPORT) PER WSDOT DETAIL G-24.50-00, SIGN SUPPORT TYPE ST-4 IN THE CONTRACT DOCUMENTS.
3. ALL SIGNS REMOVED IN THE CITY OF CAMAS SHALL BE RETURNED TO THE CAMAS STREET DEPARTMENT. CONTRACTOR TO COORDINATE WITH INSPECTOR FOR RETURN OF SIGNS.

CITY OF CAMAS PUBLIC WORKS
616 NE 4TH AVENUE
CAMAS, WA 98607
(360) 817-1560
(360) 834-1535 FAX

SIGNING AND STRIPING PLAN FOR:
NW 38TH AVE/SE 20TH ST EXTENSION
Ph. 1

OLSON LAND SURVEYORS ENGINEERS
ENGINEERING INC. 1111 BROADWAY, VANCOUVER, WA 98660

PETER A. TUCK, STATE OF WASHINGTON, PROFESSIONAL ENGINEER
9/14/12

CHANGES / REVISIONS	
DESCRIPTION:	DATE:

DESIGNED: JJW
DRAWN: JJW
CHECKED: PAT
DATE: JUNE 2012
SCALE: H: 1"=40' V:

NW 38TH AVE/SE 20TH ST EXTENSION
JOB NO. 8303.02.01
SHEET
SS1.1